


SEC. 14, TWP. 24, N RNG. 1 E, WM  
KITSAP COUNTY, WASHINGTON

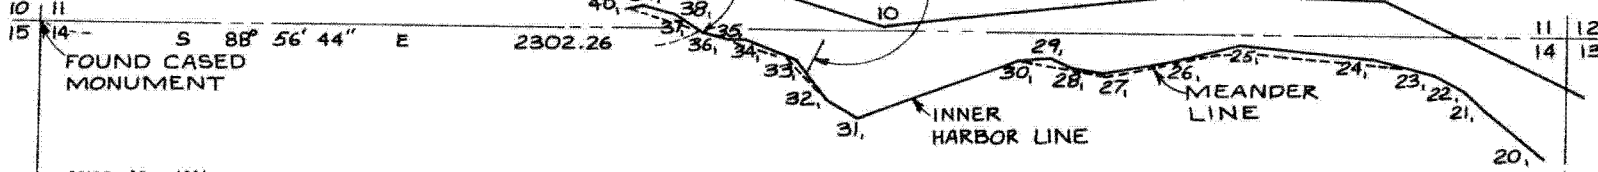


CONVERSION TABLE	CITY	P.S.N.S.
Extreme High Water (EHW)	125.15	124.8
Mean Higher High Water (MHHW)	121.45	121.1
Mean High Water (MHW)	120.55	120.2
Mean Tide Level (MTL)	116.55	116.2
Mean Lower Low Water (MLLW)	109.75	109.4
Extreme Low Water (ELW)	105.35	105.0

VERTICAL DATUM: City of Bremerton (the relationships between the City of Bremerton Datum, and the Puget Sound Naval Shipyard Datum are shown below.)

BASIS OF BEARING: Washington State Plane Coordinate System, North Zone

- REFERENCED:
- State of Washington Board of State Land Commissioners, Maps of Bremerton Tide lands showing Harbor Lines and Tide Lands as Surveyed Established and Platted by order of the Board of State Land Commissioners. And filed in the Office of the Commissioner of Public Lands on the 28th day of February A.D. 1913.
  - Right of Way Plat, Cascade Natural Gas Co. Section II and 14, TWP. 24N., RGE. 1E., W.M. Kitsap County, Washington. This Plat was done by Jones and Associates on the 6th day of November 1974.

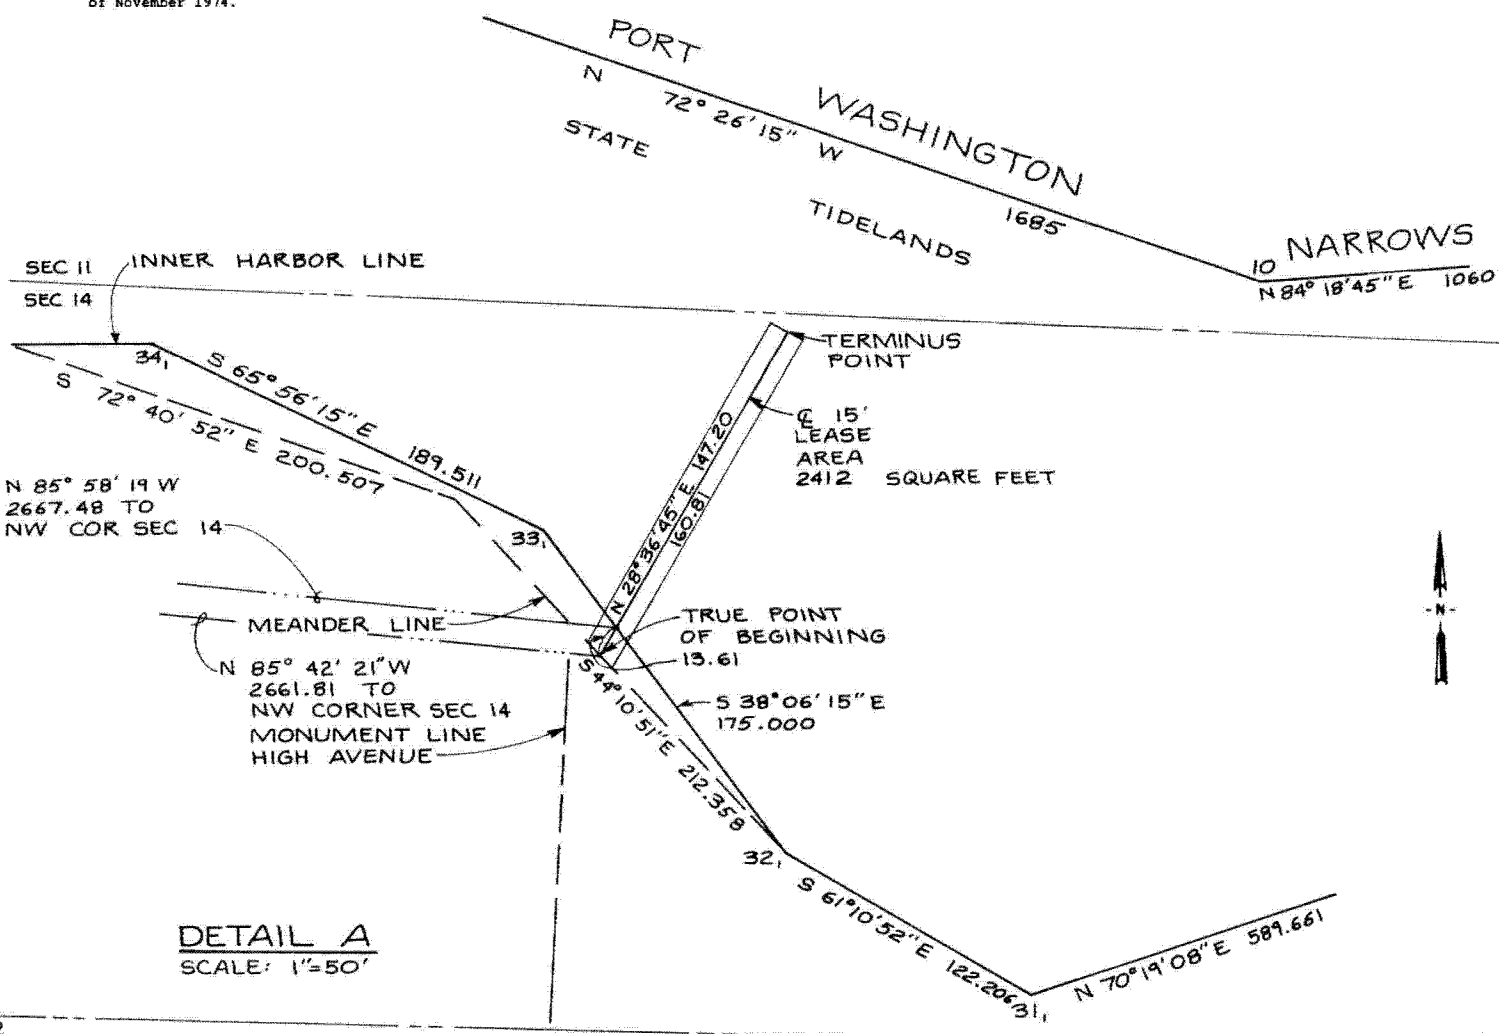

Description of Lease of Publicly Owned Aquatic Lands


A strip of land 15 feet in width, 7.5 feet left and right of the following described centerline, situated in Section 14, Township 24 North, Range 1 East, Willamette Meridian; Kitsap County, Washington:

Commencing at the Northwest corner of said Section 14; thence South 85° 42' 21" East 2661.81 feet to a point on the Meander Line per State of Washington Board of State Land Commissioners, Maps of Bremerton Tide Lands 28 February 1913 (Page 5); said point being the True Point of Beginning; thence North 28° 36' 45" East 13.61 feet to a point on the Inner Harbor Line, said point being South 85° 58' 19" East 2667.48 feet from the Northwest corner of Section 14; thence North 28° 36' 45" East 147.20 feet to the Terminus Point of said strip.

The described strip contains 0.06 acres.

AUDITOR'S SURVEY NUMBERS:

1424011103	1424011210B	14240113102	14240114104
1424011202	1424011202	1424011303	14240114202
1424011302	1424011304	14240113304	14240114304
1424011403	14240112404	14240113402	14240114404

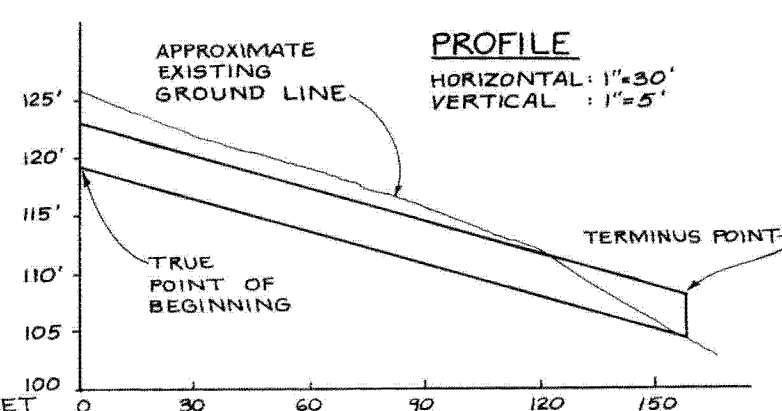

DRAWN BY: WJM CHECKED BY: JLC JOB NO. S 12400.06


DATE: 9-26-83 SCALE: 1" = 400' SHEET 1 OF 1

RECORDER'S CERTIFICATE

Filed for record this 15th day of June, 1984 at 3:00 P.M. in Book 21 of Surveys at page 036 at the request of CH2M HILL.

SHERRILL RICE, by R. L. [Signature] Manager Superintendent of Records

AUDITOR'S FILE NO. 8406150186

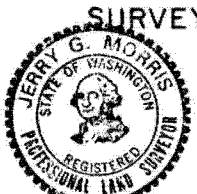

SURVEYOR'S CERTIFICATE

This map correctly represents a survey made by me or under my direction in conformance with the requirements of the Survey Recording Act at the request of CITY OF BREMERTON in SEPTEMBER, 1983.

Jerry G. Morris  
Certificate No. 17673

RECORD SURVEY  
For  
CITY OF BREMERTON  
DNR LEASE  
HIGH AVE. OUTFALL